

Conv

CHILDRESS, TEXAS
AIR FORCE STATION
RECORD DRAWING
RADIO RANGE LOCATION

IN 1 SHEET

SHEET NO. 1

SCALE

50 0 50 100 3000
PLOT PLAN
SCALE IN FEET

0 3000 6000
VICINITY MAP
SCALE IN FEET

U.S. ENGINEER OFFICE, DENISON, TEXAS

NOV. 1943

PREPARED BY
CLARKSON, PELICH, GOREN & RADY
ARCHITECT-ENGINEERS

RECOMMENDED

CAPT. *O. B. R. Scale*
CHIEF OF ENGINEERS
PROJECTS DIVISION

SUBMITTED

C. Clarkson
CHIEF ENGINEERING BRANCH
PROJECTS DIVISION

APPROVED


C. Clarkson
MAJ. *C. Clarkson*
ACTING DISTRICT ENGINEER

R-127B-373

EXHIBIT

③

③

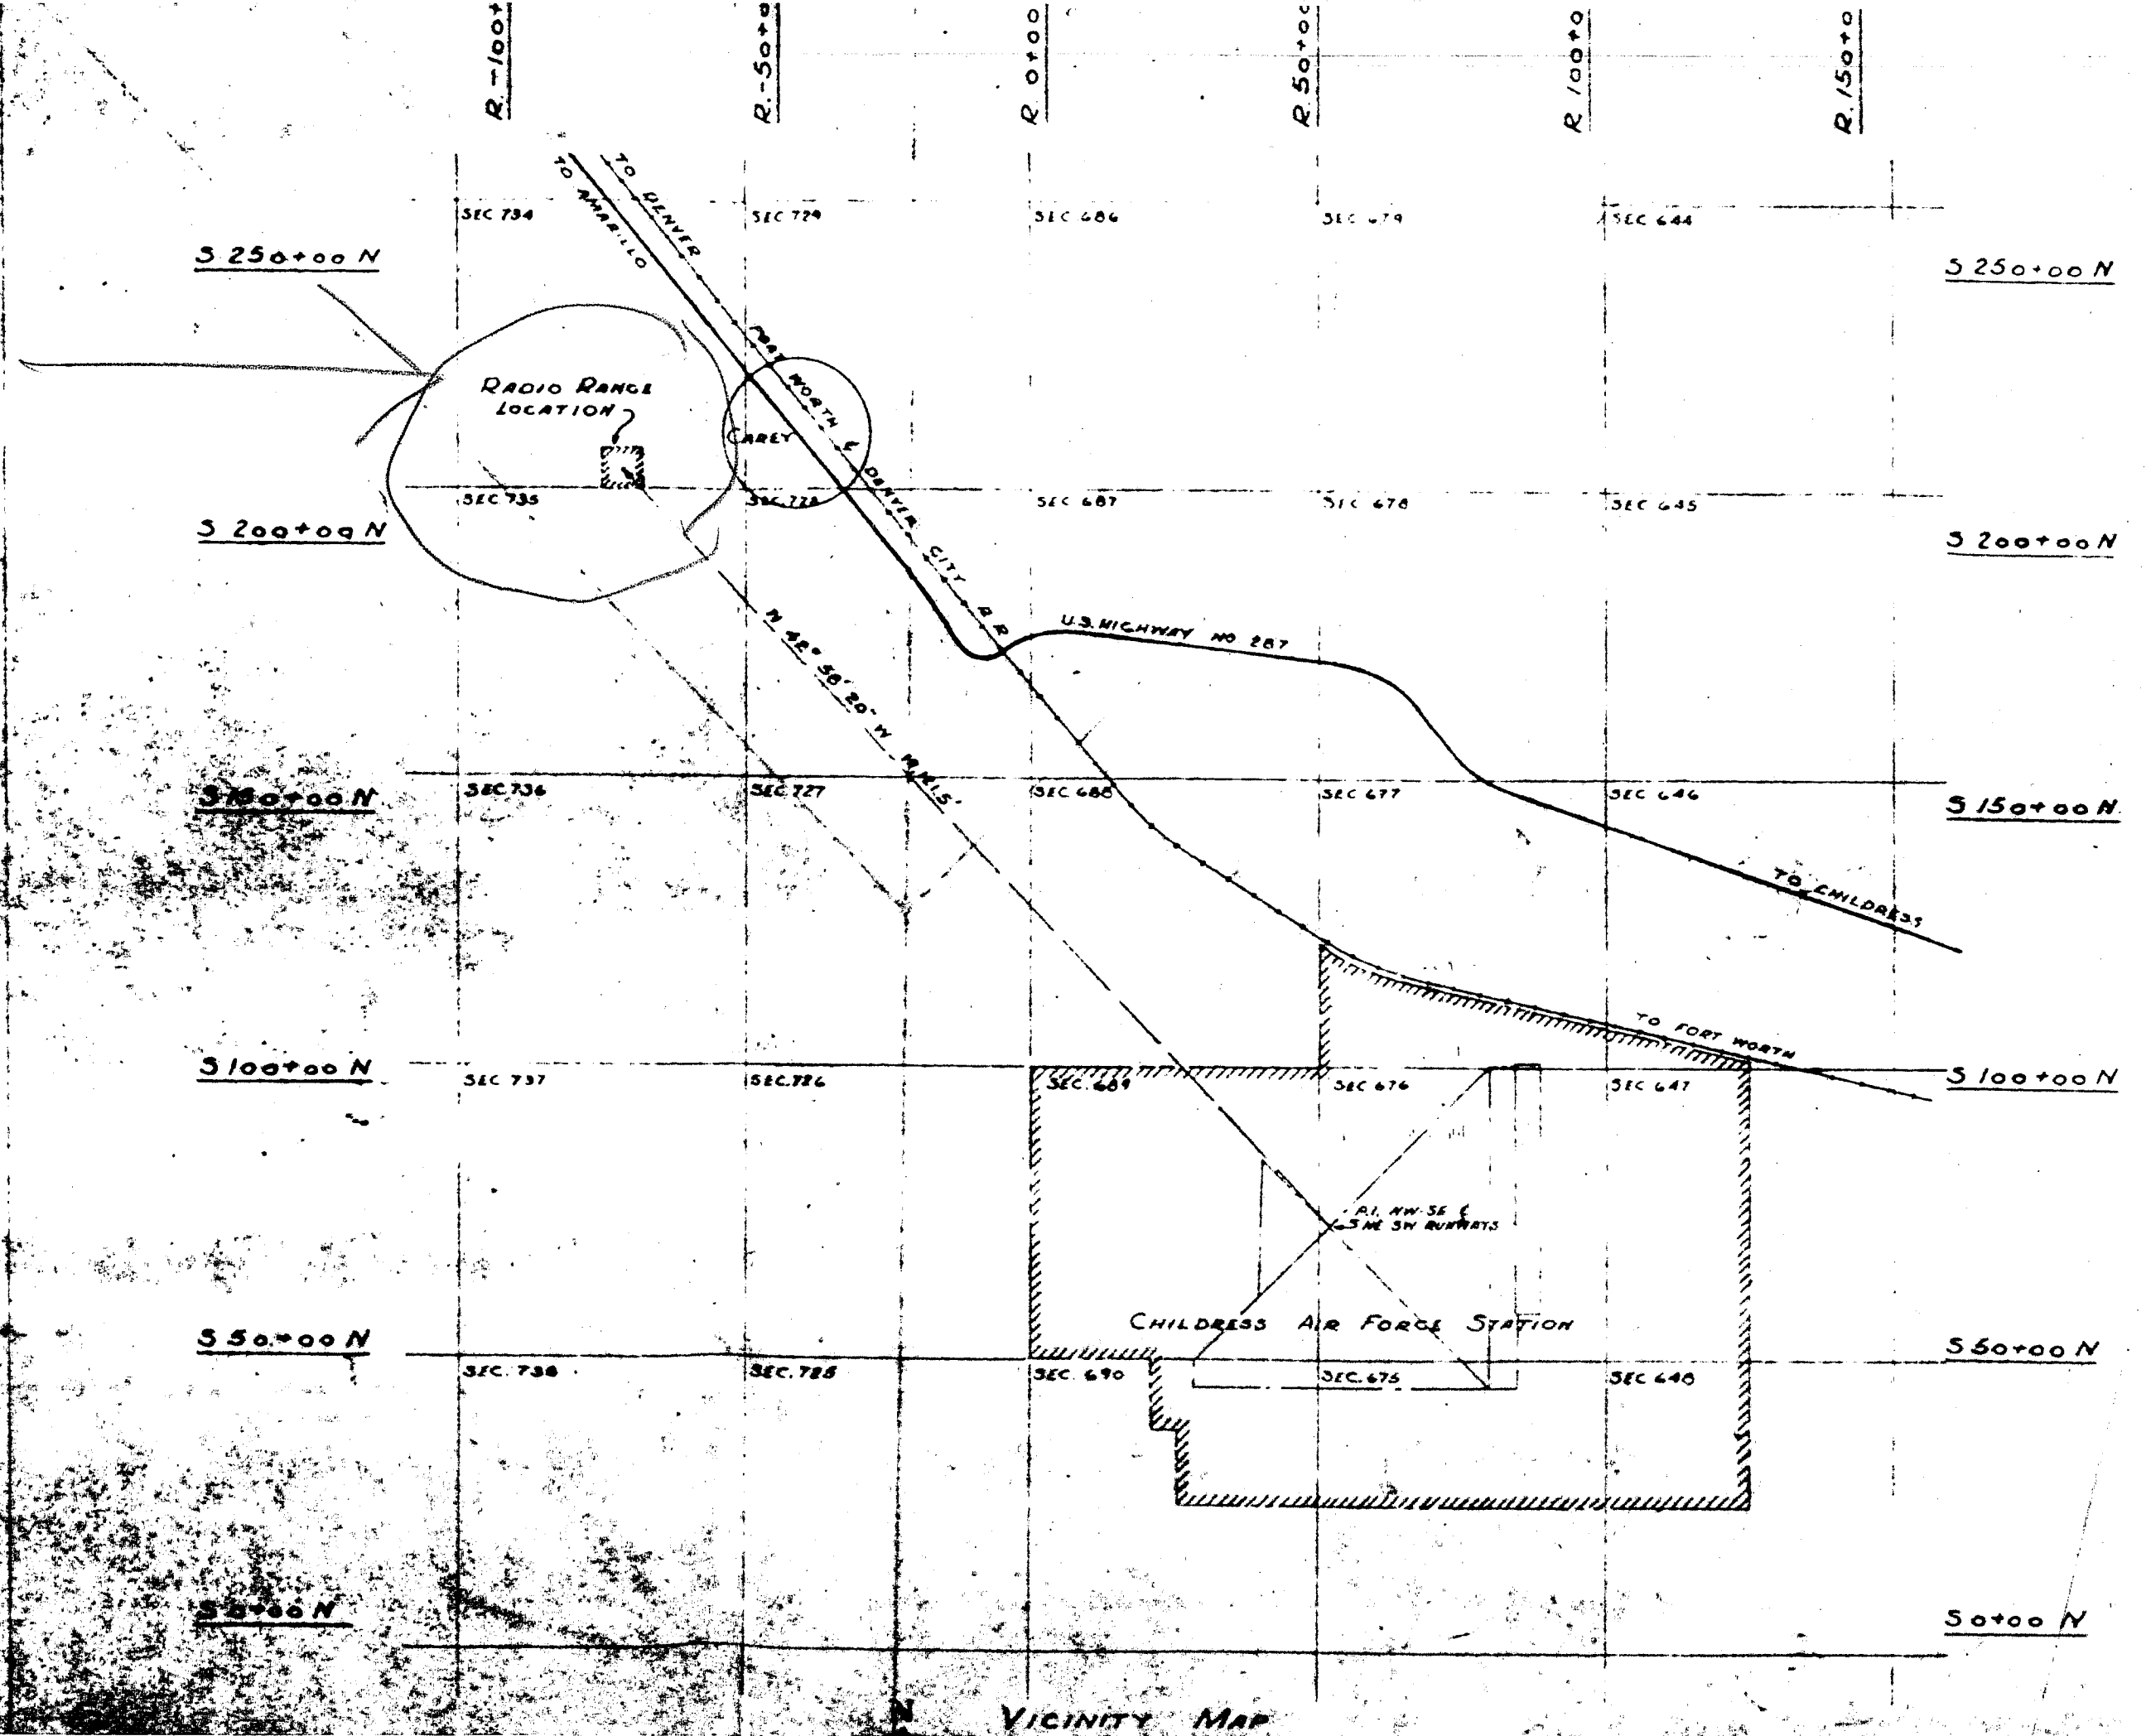

VICINITY MAP

SHILOH ARMY AIRFIELD RADIO RANGE

W-TEX 203

FCA 10-68